

Date: Monday, 21/04/2008 2:41:45 PM  
 User: Linda Lacelle

## Process Sheet

Customer	: CC-DAR01 Dart Aerospace Ltd.	Drawing Name	: B67-43001
Job Number	: 38704		
Estimate Number	: 10804		
P.O. Number	:	Part Number	: PB6743001169
This Issue	: 21/04/2008	S.O. No. :	Drawing Number : PB6743001169
Prsht Rev.	: NC	Project Number	:
First Issue	: / /	Drawing Revision	: B1
Previous Run	: 00015	Material	:
Written By	:	Due Date	: 28/04/2008
Checked & Approved By	:	Qty:	1 Um: Each
Comment	:		

## Additional Product

Job Number:



Seq. #:	Machine Or Operation:	Description :
---------	-----------------------	---------------

1.0	WATER JET	FLOW WATER JET
-----	-----------	----------------



Comment: FLOW WATER JET

CUT PER DRWG B67-43001 REV.B1

IB 8-4-22

2.0	M6061T6S090	6061-T6 .090 Sheet
-----	-------------	--------------------



Comment: Qty.: 0.6500 sf(s)/Unit Total: 0.6500 sf(s)

6061-T6 .090 Sheet

19059

IB 8-4-22

3.0	QC2	INSPECT PARTS AS THEY COME OFF MACHINE
-----	-----	----------------------------------------



IB 8-4-22

Comment: INSPECT PARTS AS THEY COME OFF MACHINE

4.0	QC8	SECOND CHECK
-----	-----	--------------



Comment: SECOND CHECK

5.0	PACKAGING 1	PACKAGING RESOURCE #1
-----	-------------	-----------------------



Comment: PACKAGING RESOURCE #1

ID &amp; STK

WA

08-04-23

6.0	QC21	FINAL INSPECTION/W/O RELEASE
-----	------	------------------------------



Comment: FINAL INSPECTION/W/O RELEASE

08/04/24

Job Completion




mf

08-04-23

RELEASED  
-7-06-4-20

10/28/83  
3840

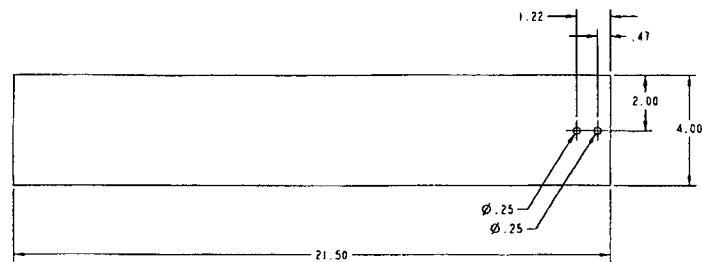


② -169 LONG SUPPORT PLATE

MATL: .090 THK, 6061-T6, 00-A-250/11  
SCALE 0.500


930

X1 ~~WJ~~ ~~ALOT~~ ~~PUT~~ ~~CLIFF~~

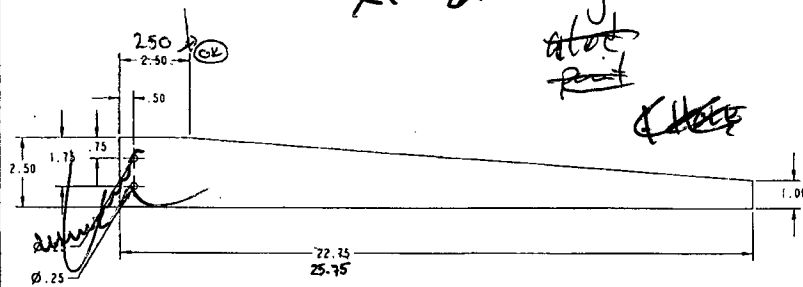




④ -167 LONG SIDE PLATE

MATL: .125 THK, 6061-T6, 00-A-250/11  
SCALE 0.500

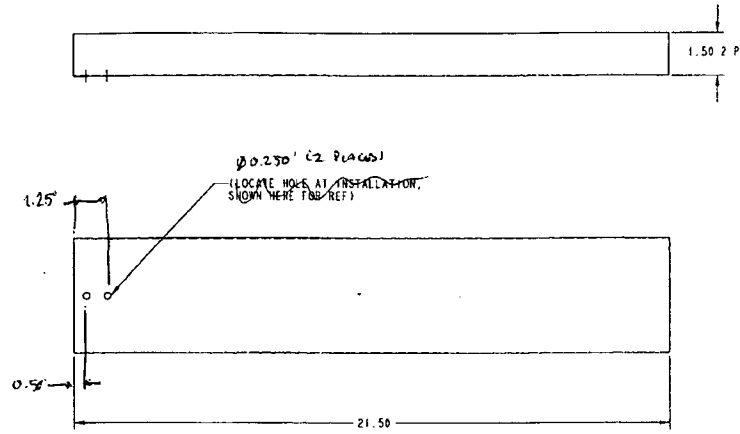

② -173 COVER PLATE

MATL: .032 THK, 2024-T3, 00-A-250/4  
SCALE 0.500

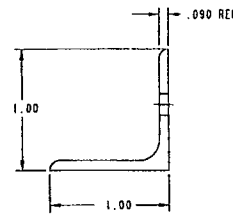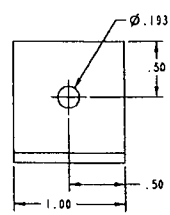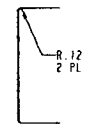

②④ -171 MOUNTING PLATE

MATL: AND10133-1002, 6061-T6, 00-A-200/8F  
ALT MATL: .090 THK, 6061-T6, 00-A-250/11  
SCALE 2.000

PREMIER AVIATION, INC.			
2001 Aviation Parkway, Grand Prairie, Texas 75038			
DATE: 08-08-83	REV: 0	QTY: 867-43001	REV: B1
NAME: 0805V8		PAGE: 27 of 45	

ORIGINAL

